


ONE CLEVELAND CENTER  
www.1development.com  
1375 EAST NINTH STREET  
CLEVELAND, OH 44114  
216.781.8980

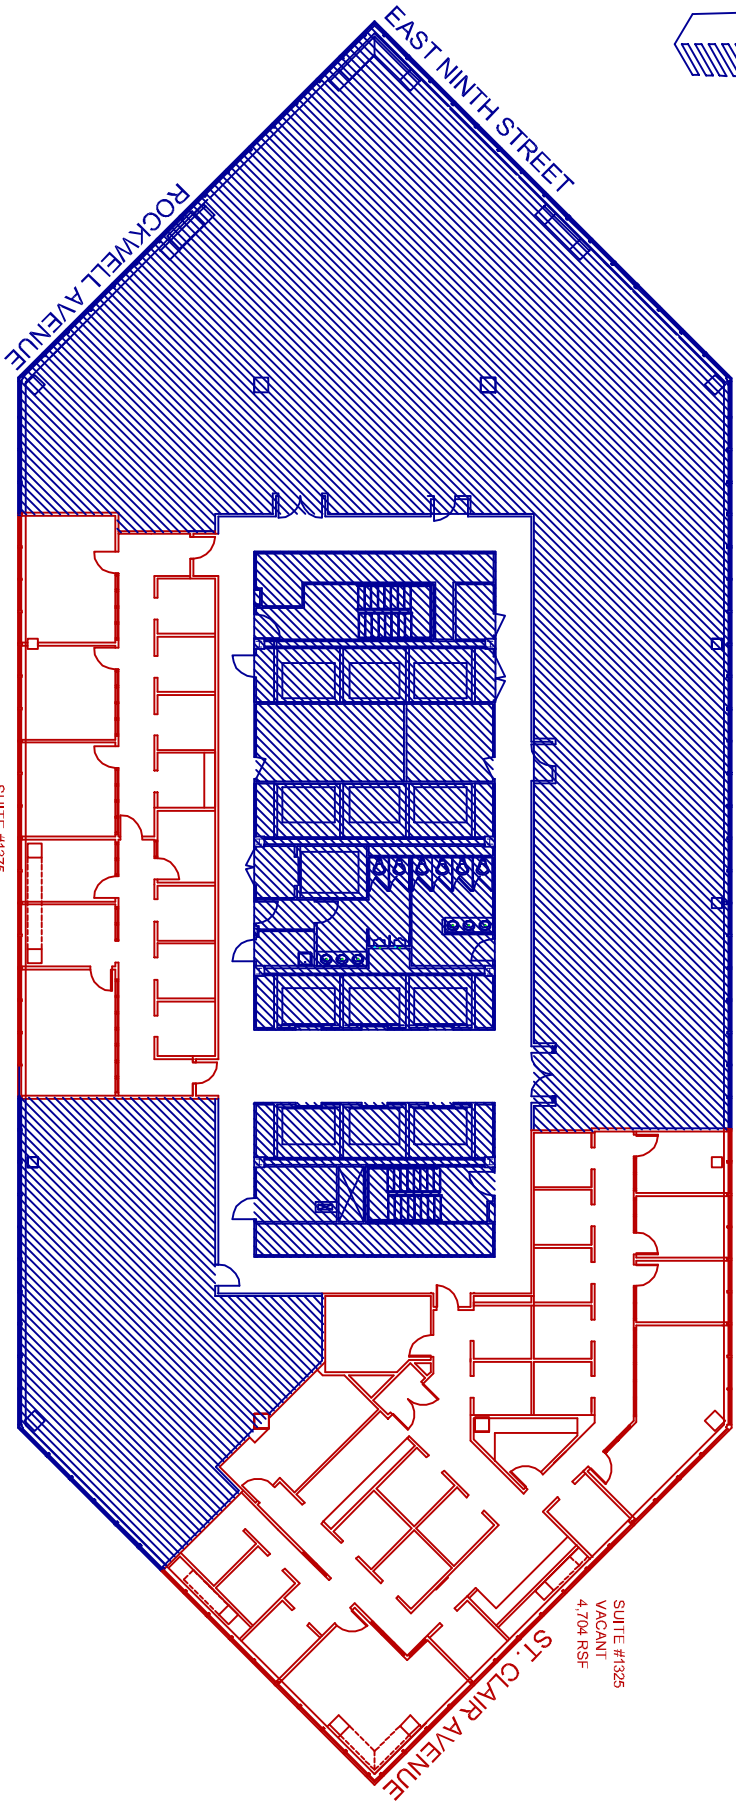

SUITE #1375  
VACANT  
2,087 RSF

SUITE #1325  
VACANT  
4,704 RSF

 LEVEL 13 (AS-BUILT)  
SCALE: NTS