


ONE CLEVELAND CENTER
www.1clevelandcenter.com
1375 EAST NINTH STREET
CLEVELAND, OH 44114
216.731.8980

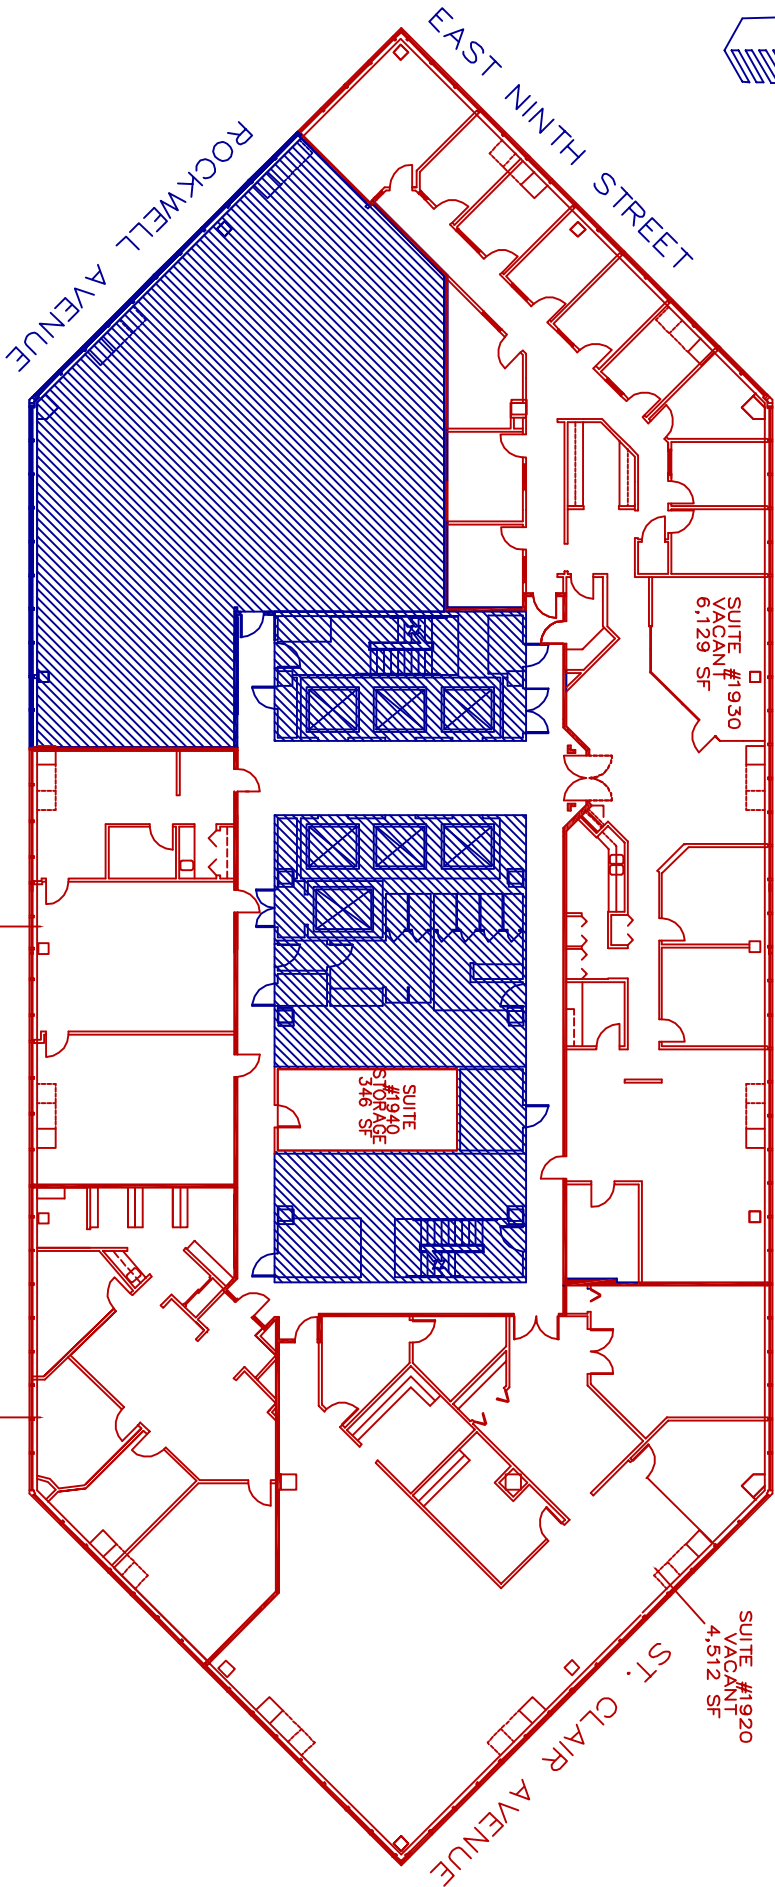

LEVEL 19 (AS-BUILT)
SCALE: NTS

SUITE #1960
VACANT
1,785 SF

SUITE #1970
VACANT
2,188 SF

SUITE #1930
VACANT
6,129 SF

SUITE #1940
STORAGE
348 SF

SUITE #1920
VACANT
4,512 SF

ROCKWELL AVENUE

EAST NINTH STREET

ST. CLAIR AVENUE