




ONE CLEVELAND CENTER
www.1clevelandcenter.com
1375 EAST NINTH STREET
CLEVELAND, OH 44114
216.781.8980

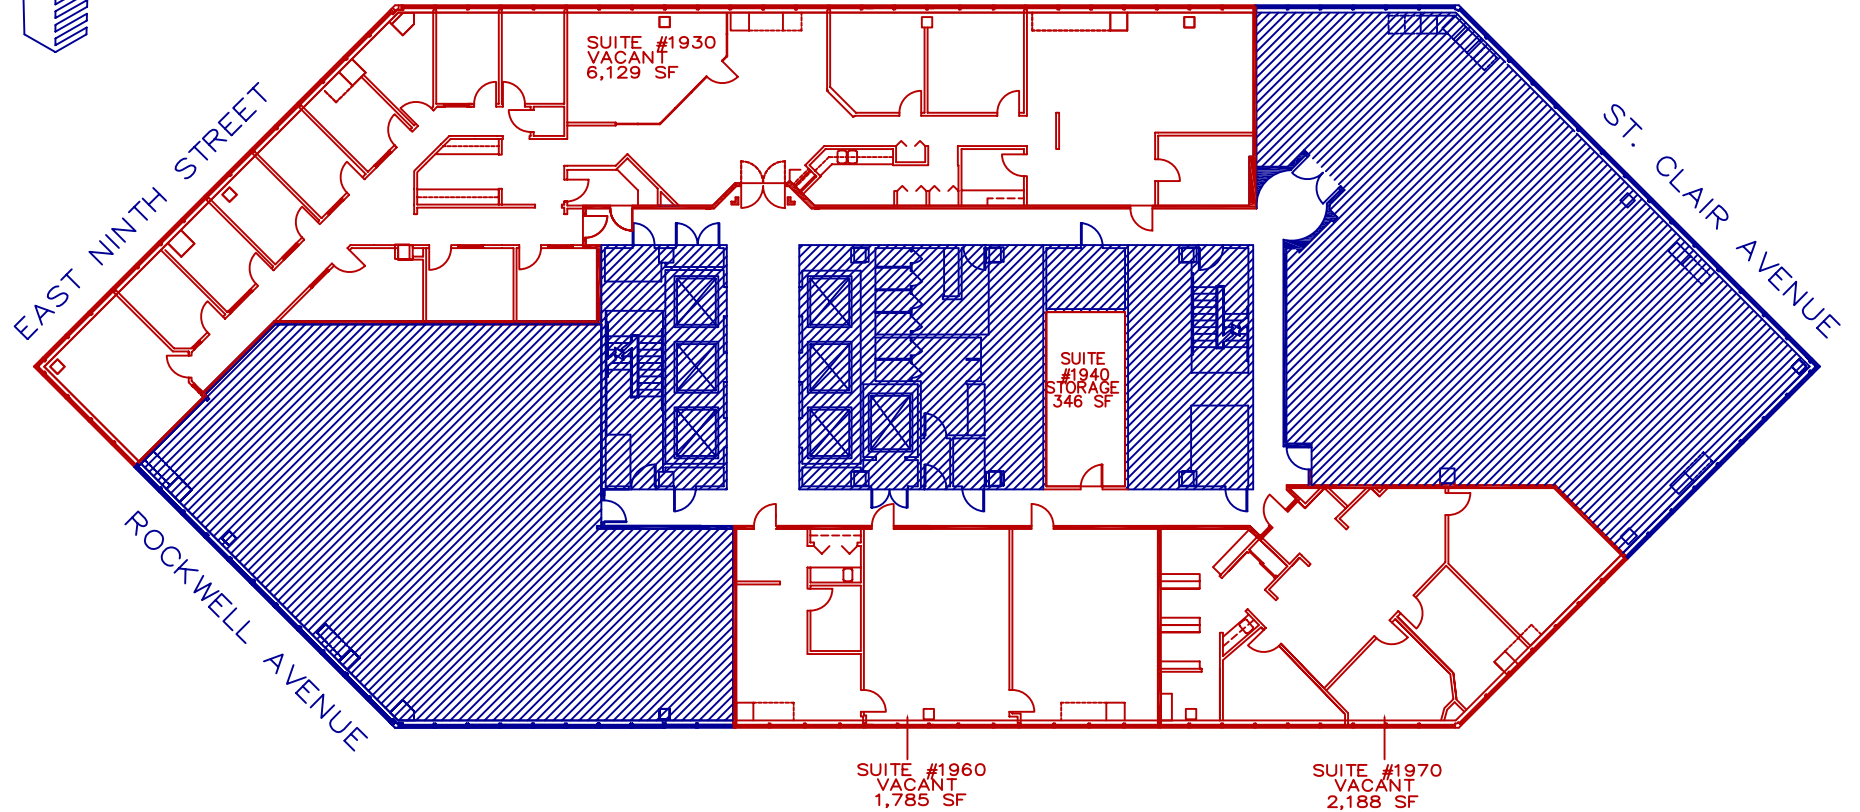

 **LEVEL 19 (AS-BUILT)**
SCALE: NTS