


ONE CLEVELAND CENTER
www.1clevelandcenter.com
1375 EAST NINTH STREET
CLEVELAND, OH 44114
216.781.8980

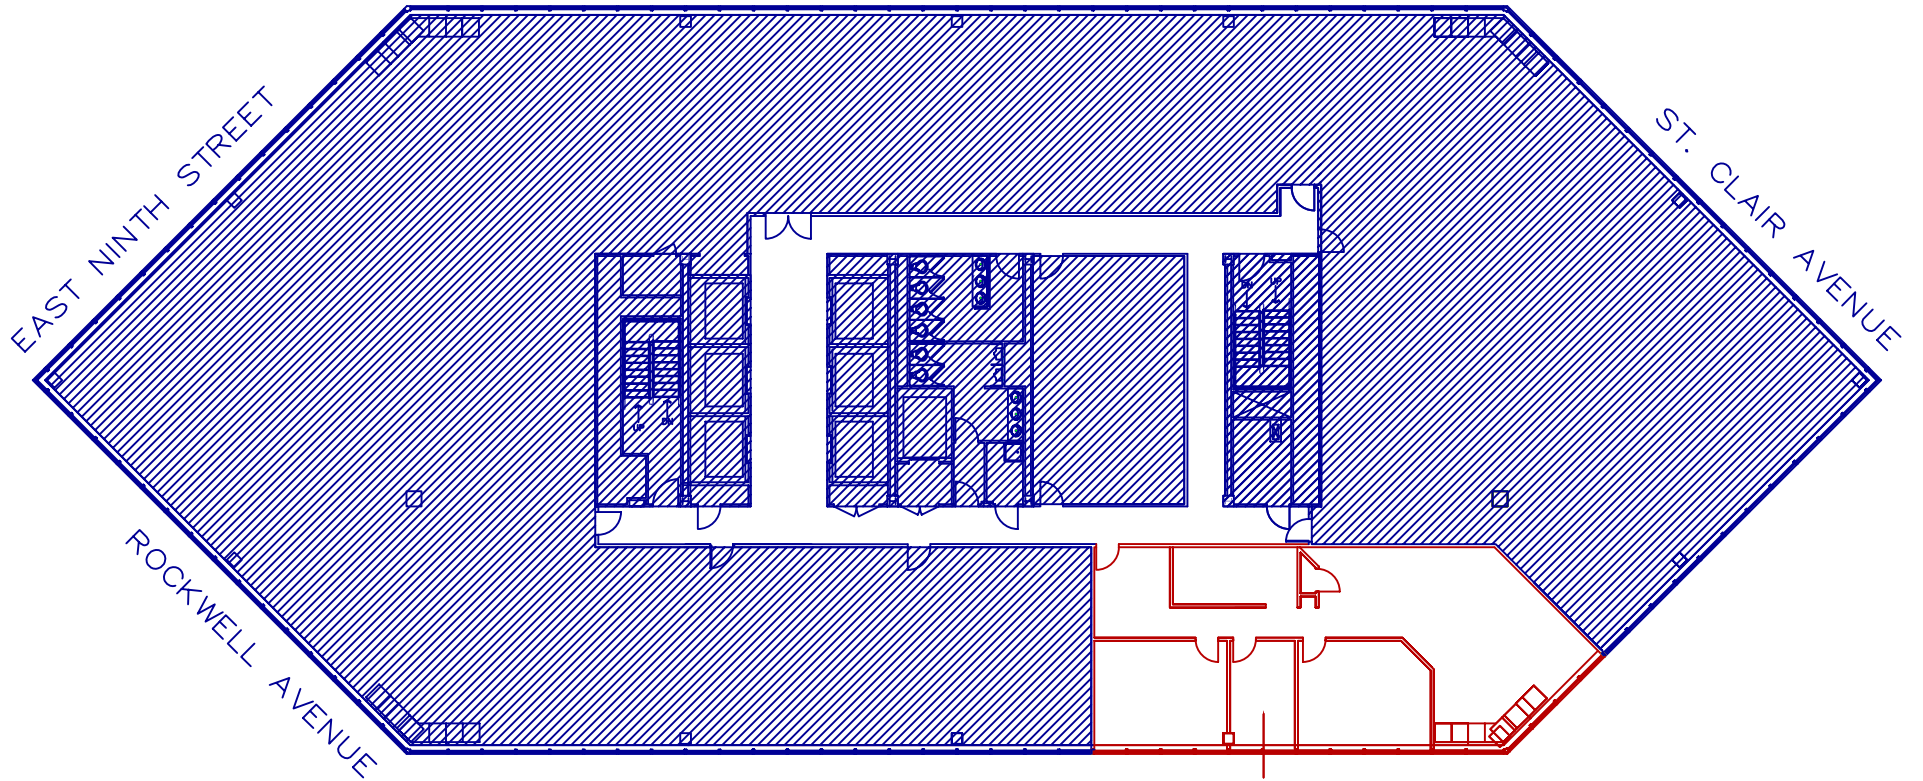

SUITE #2250
VACANT
2,511 SF

LEVEL 22 (AS-BUILT)

SCALE: NTS

