


ONE CLEVELAND CENTER
www.1clevelandcenter.com
1375 EAST NINTH STREET
CLEVELAND, OH 44114
216.781.8880

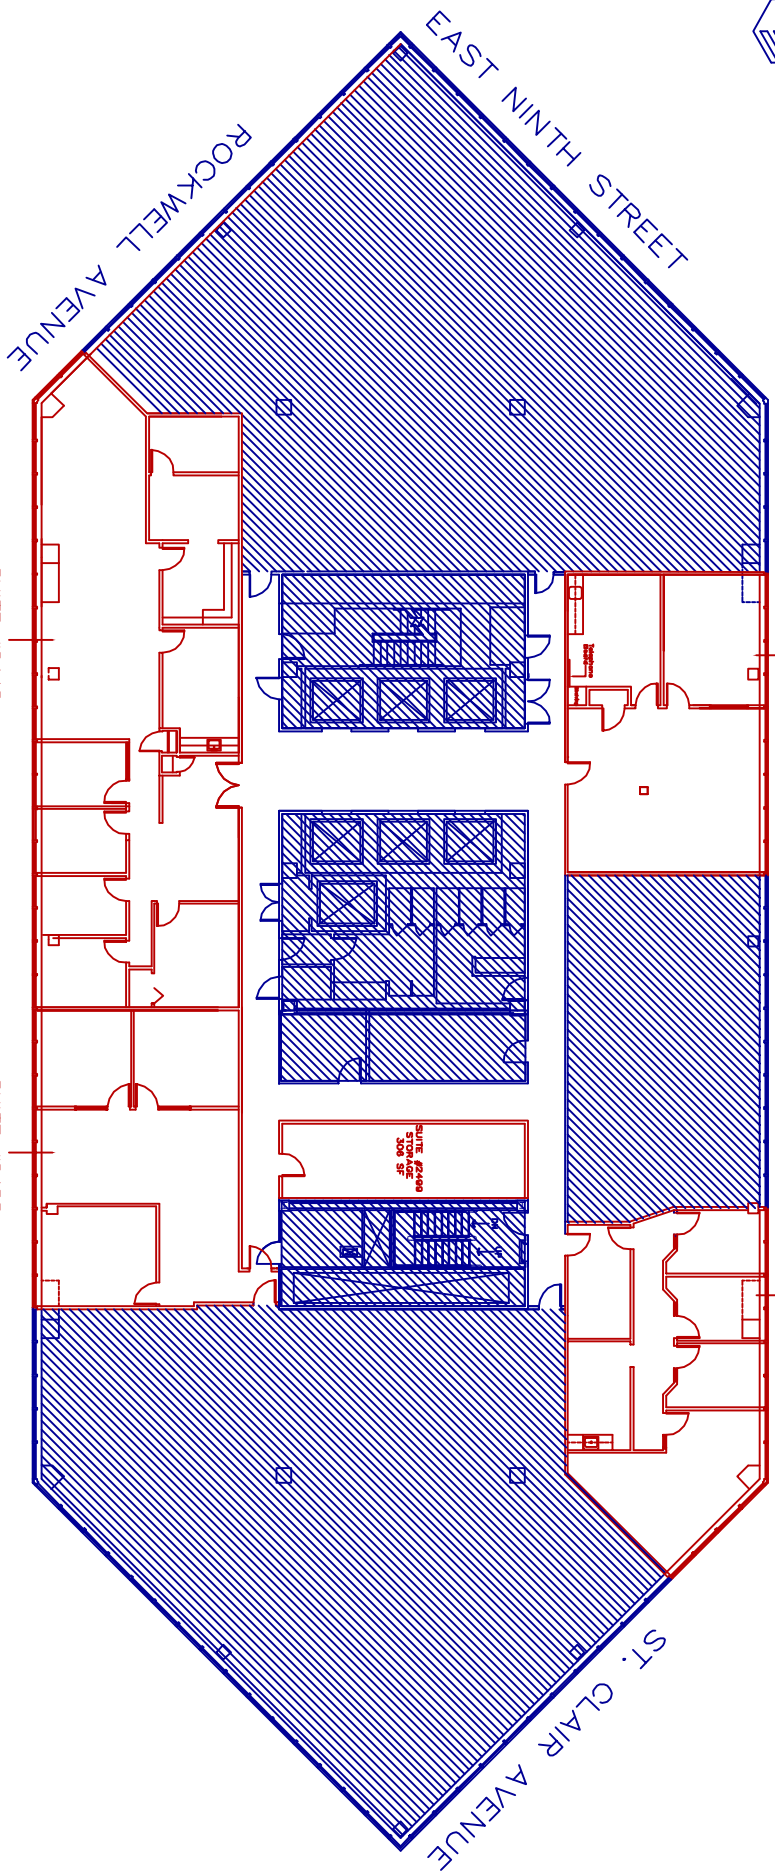

LEVEL 24 (AS-BUILT)
SCALE: NTS

SUITE #2440
VACANT
2,875 RSF

SUITE #2455
VACANT
1,375 SF

SUITE #2425
VACANT
1,348 SF

SUITE #2460
VACANT
1,791 SF

SUITE #2450
STORAGE
308 SF