


ONE CLEVELAND CENTER  
www.1clevelandcenter.com  
1375 EAST NINTH STREET  
CLEVELAND, OH 44114  
216.781.8980

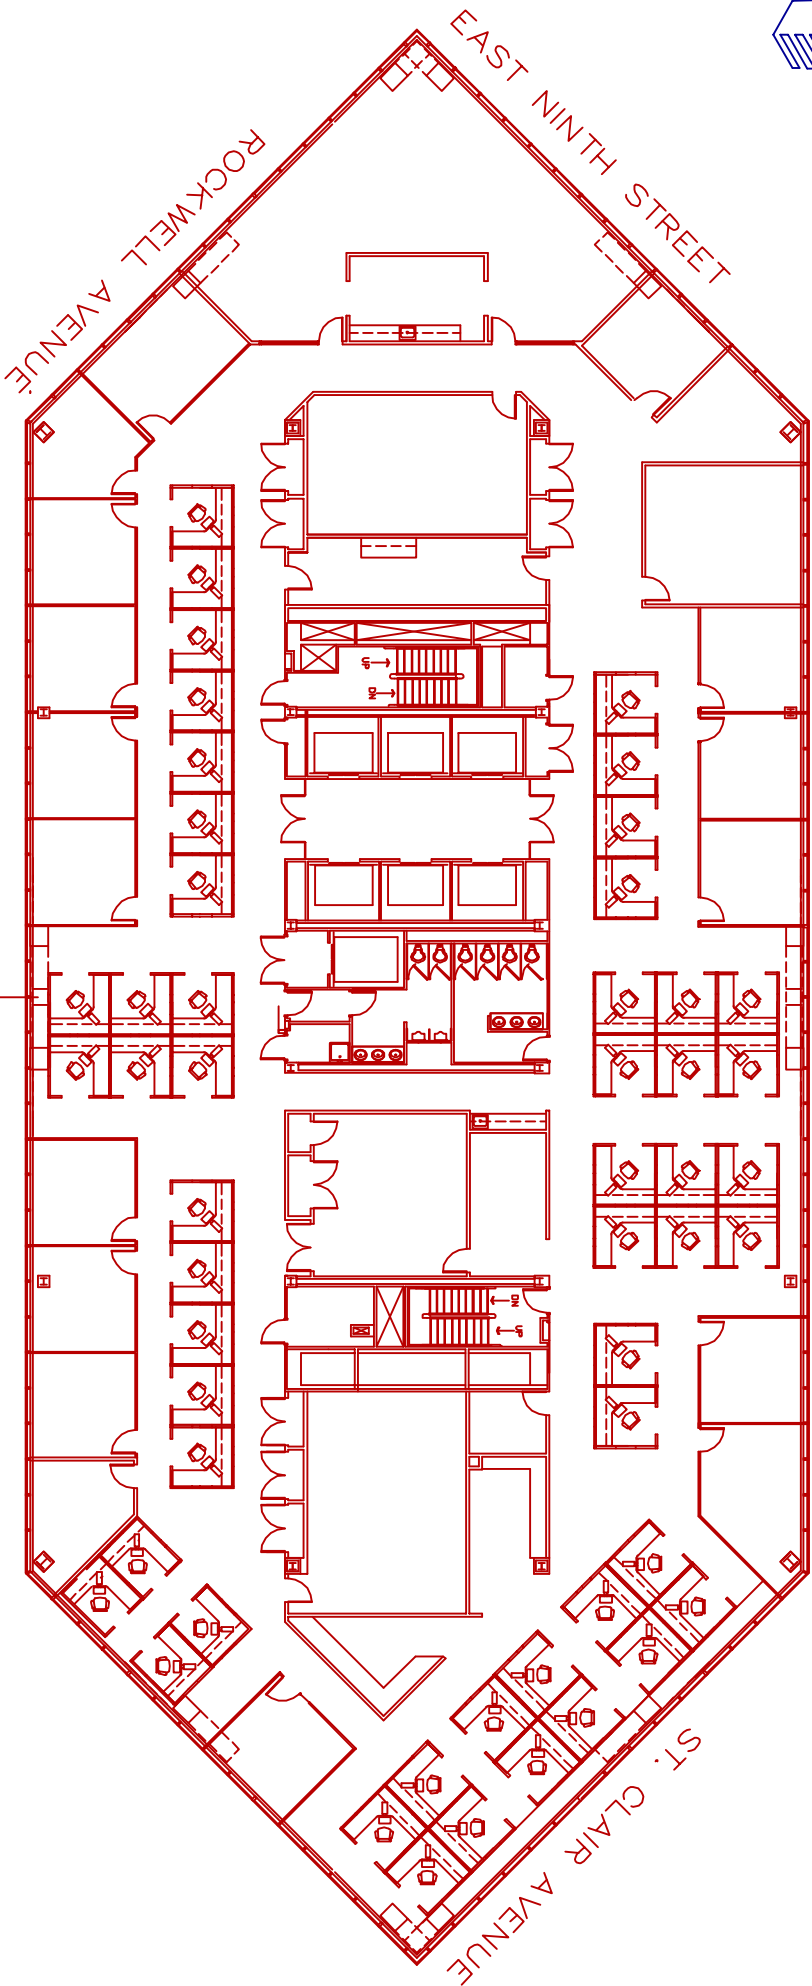

 LEVEL 29 (AS-BUILT)  
SCALE: NTS