




ONE CLEVELAND CENTER
www.1clevelandcenter.com
1375 EAST NINTH STREET
CLEVELAND, OH 44114
216.781.8980

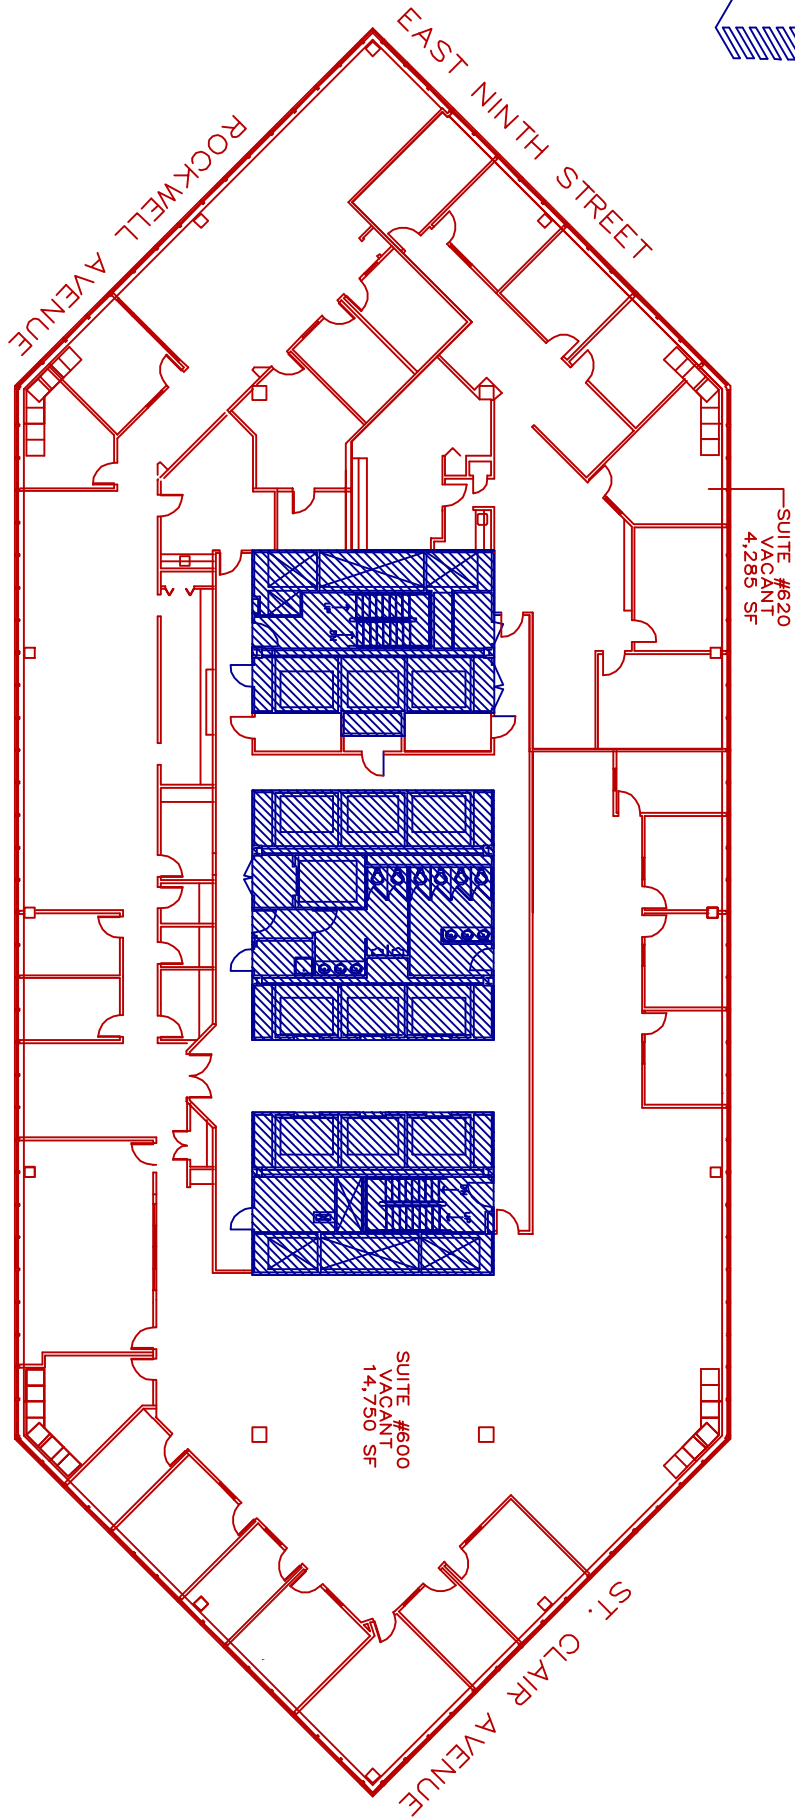

LEVEL 6 (AS-BUILT)
SCALE: NTS